THE DISTRICT II
AT KING FARM

702
KING FARM BLVD

26,478 SF

4TH FLOOR
AS-BUILT

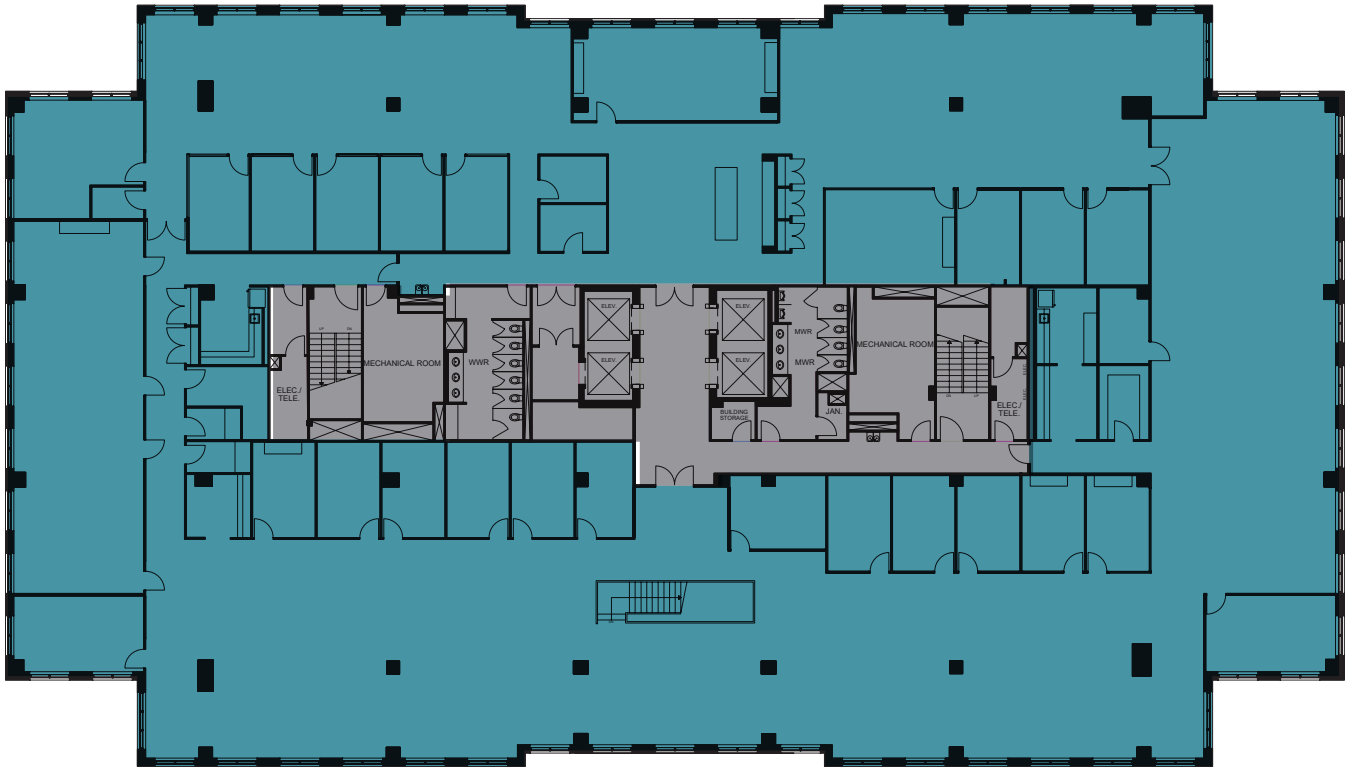

BANYAN STREET
CAPITAL

CUSHMAN &
WAKEFIELD